


Customer Information Sheet

DRAWING No.: S1711-XXR IF IN DOUBT - ASK © NOT TO SCALE THIRD ANGLE PROJECTION ALL DIMENSIONS IN mm

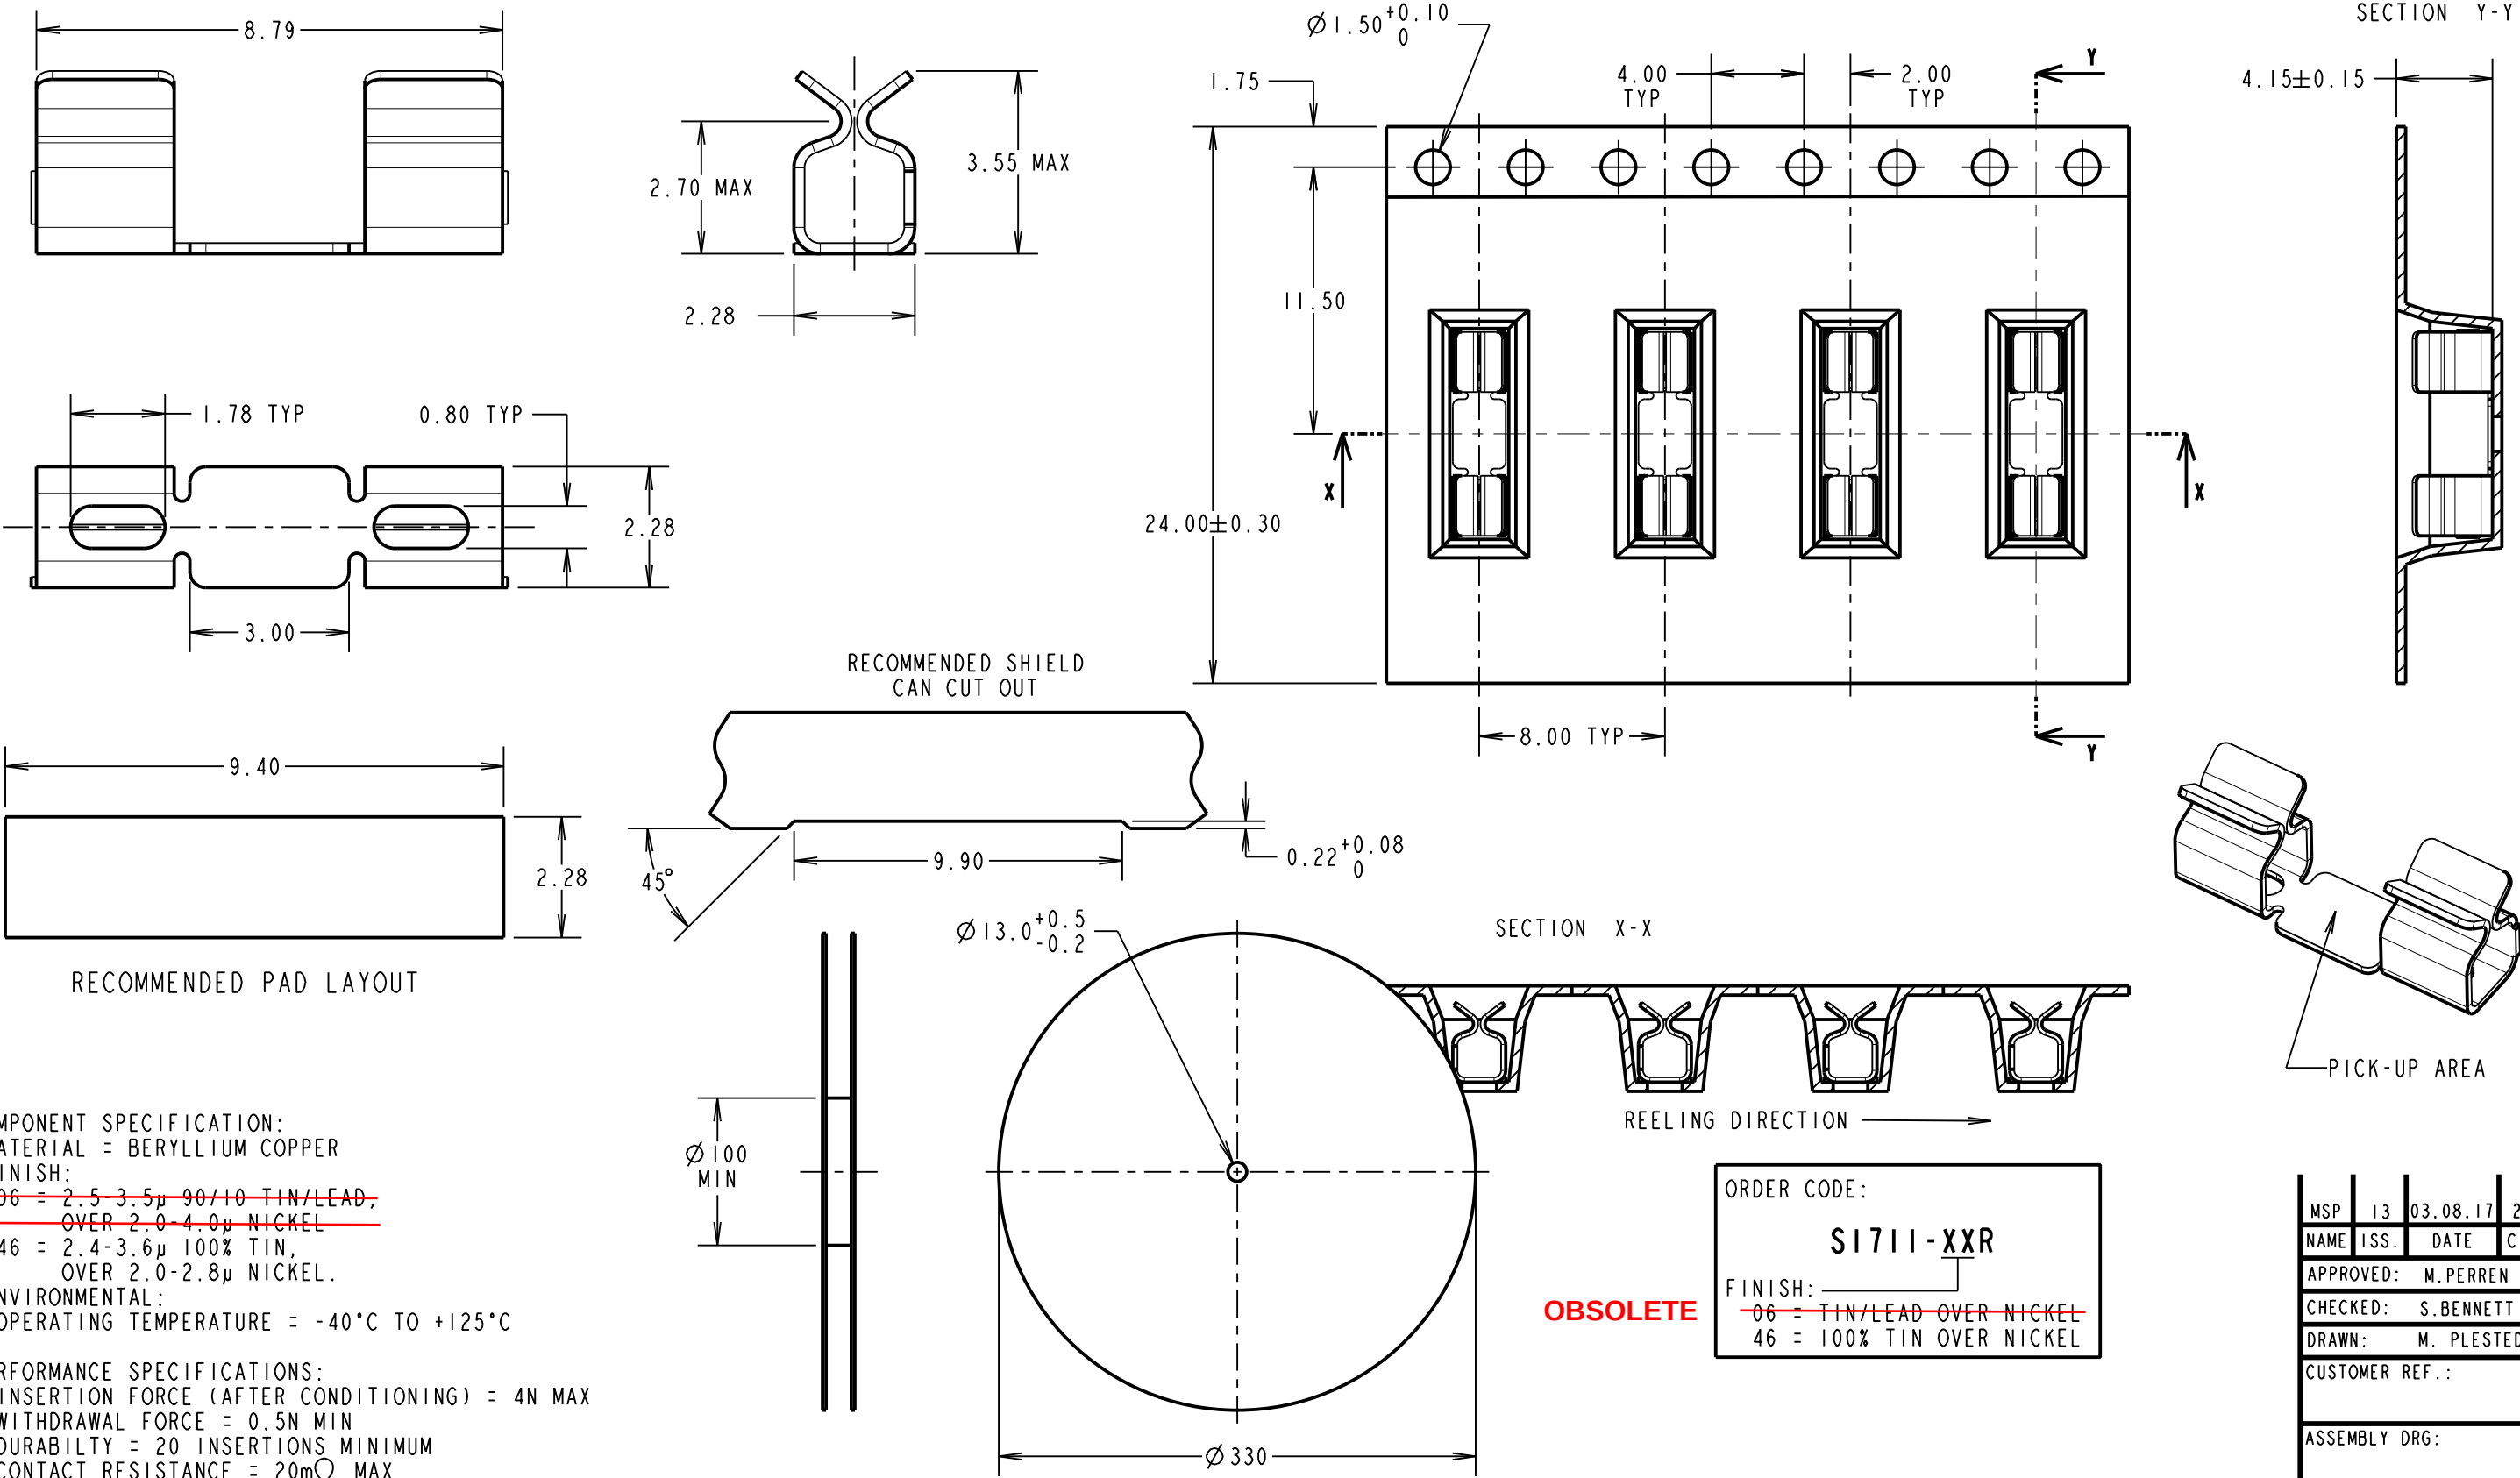

COMPONENT SPECIFICATION:
MATERIAL = BERYLLIUM COPPER
FINISH:
~~06 = 2.5-3.5µ 90/10 TIN/LEAD,~~
~~OVER 2.0-4.0µ NICKEL~~
46 = 2.4-3.6µ 100% TIN,
OVER 2.0-2.8µ NICKEL.
ENVIRONMENTAL:
OPERATING TEMPERATURE = -40°C TO +125°C

PERFORMANCE SPECIFICATIONS:
INSERTION FORCE (AFTER CONDITIONING) = 4N MAX
WITHDRAWAL FORCE = 0.5N MIN
DURABILITY = 20 INSERTIONS MINIMUM
CONTACT RESISTANCE = 20mΩ MAX
SHIELD THICKNESS = 0.17mm - 0.30mm

NOTES:
1. QUANTITY PER REEL = 1,900.
2. THIS PRODUCT IS TAPED AND REELED IN ACCORDANCE WITH EIA-481 (ELECTRONIC INDUSTRIES ASSOCIATION).

HARWIN
www.harwin.com
technical@harwin.com

THIS DRAWING AND ANY INFORMATION OR DESCRIPTIVE MATTER SET OUT HEREON ARE CONFIDENTIAL AND COPYRIGHT PROPERTY OF THE HARWIN GROUP AND MUST NOT BE DISCLOSED, LOANED, COPIED OR USED FOR MANUFACTURING, TENDERING OR FOR ANY OTHER PURPOSE WITHOUT THEIR WRITTEN PERMISSION.

TOLERANCES
X. = ±1mm
X.X = ±0.25mm
X.XX = ±0.10mm
X.XXX = ±0.01mm
ANGLES = ±5°
UNLESS STATED

MATERIAL: SEE ABOVE
FINISH: SEE ABOVE
S/AREA: mm²

TITLE: SMT RFI SHIELD CLIP IN TAPE AND REEL
DRAWING NUMBER: S1711-XXR
ASSEMBLY DRG:
MSP 13 03.08.17 20719
NAME ISS. DATE C/NOTE
APPROVED: M.PERREN
CHECKED: S.BENNETT
DRAWN: M. PLESTED
CUSTOMER REF.:
SHT 2 OF 2