

THIS DRAWING IS UNPUBLISHED. RELEASED FOR PUBLICATION – , – .
© COPYRIGHT – By – ALL RIGHTS RESERVED.

LOC	DIST
AD	00

REVISIONS

P	LTR	DESCRIPTION	DATE	DWN	APVD
	G2	REVISED PER ECO-11-004587	11MAR11	RK	HMR

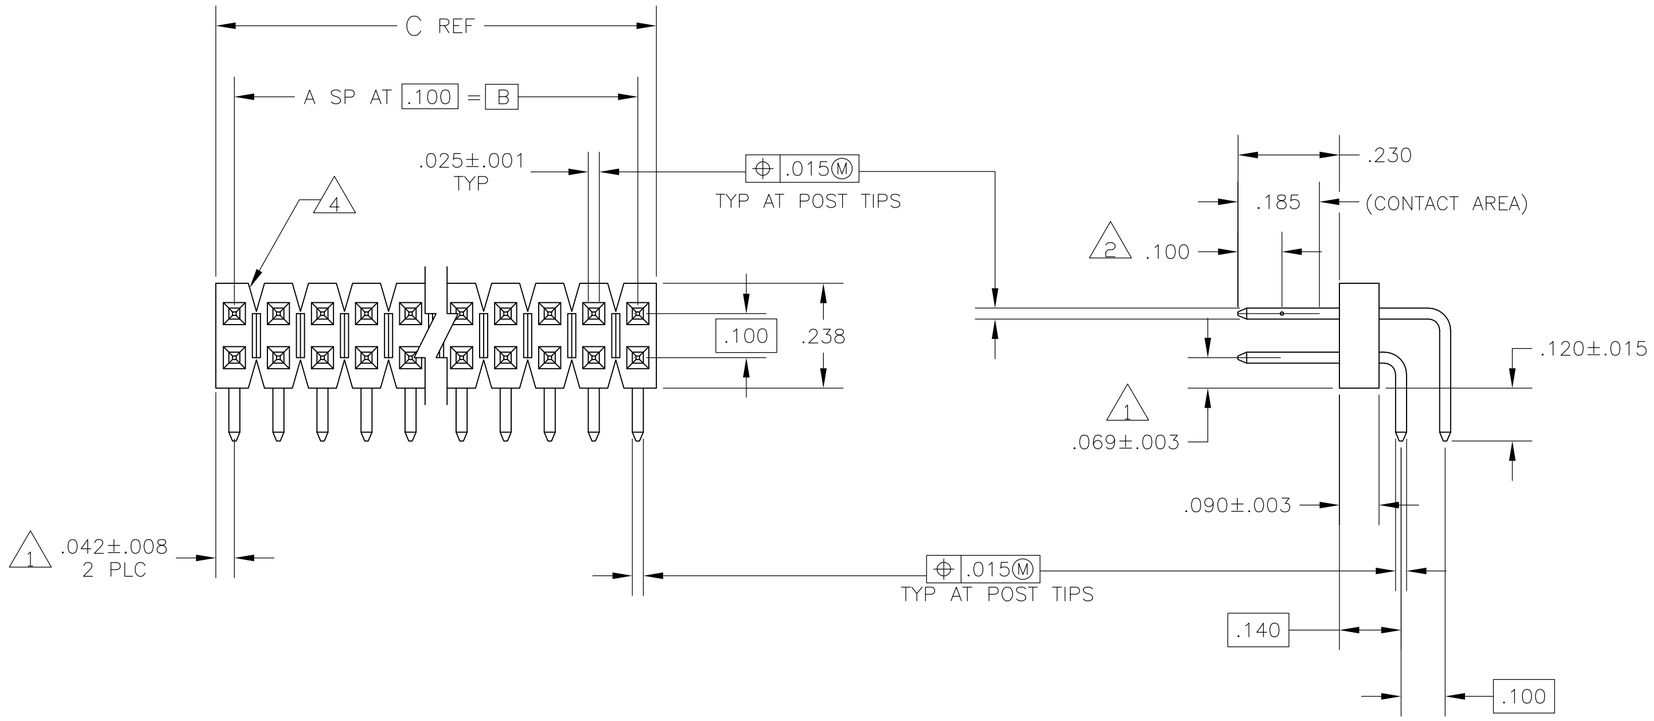

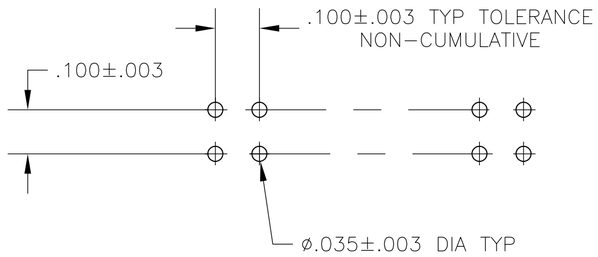

RECOMMENDED HOLE LAYOUT

THIS DRAWING IS A CONTROLLED DOCUMENT.		DWN H MOLL 23-10-87	TE Connectivity
DIMENSIONS: INCHES	TOLERANCES UNLESS OTHERWISE SPECIFIED: 0 PLC ± – ; 1 PLC ± – ; 2 PLC ± – ; 3 PLC ± .005 ; 4 PLC ± – ; ANGLES ± –	CHK T. CLARK 23-10-87	NAME HEADER ASSY, MOD II, BREAKAWAY, DOUBLE ROW, .100X.100 C/L, RIGHT ANGLE, WITH .025 SQ POSTS
		APVD T. CLARK 29-10-87	
		PRODUCT SPEC —	
		APPLICATION SPEC —	SIZE A2 · CAGE CODE 00779 · DRAWING NO C-103326 · RESTRICTED TO —
MATERIAL HOUSING: FLAME RETARDENT THERMOPLASTIC, COLOR: BLACK POSTS: PHOS BRONZE	FINISH SEE TABLE	WEIGHT —	CUSTOMER DRAWING · SCALE 4:1 · SHEET 1 OF 2 · REV G2

103326

THIS DRAWING IS UNPUBLISHED. RELEASED FOR PUBLICATION -,- .
© COPYRIGHT - By - ALL RIGHTS RESERVED.

LOC	DIST
AD	00

REVISIONS

P	LTR	DESCRIPTION	DATE	DWN	APVD
	-	SEE SHEET 1	-	-	-

△1 THE NOTED DIMENSIONS APPLY AT THE INTERSECTION OF THE POST AND HOUSING

△2 POINT OF MEASUREMENT FOR PLATING THICKNESS.

3 ASSEMBLY MAY BE BROKEN TO THE DESIRED NUMBER OF POSITIONS

△4 BREAKAWAY NOTCH ANGLE CAN BE ORIENTED TO THE RIGHT (AS SHOWN) OR TO THE LEFT

△5 .000015 GOLD IN THE CONTACT AREA, .000100-.000200 MATTE TIN-LEAD ON THE SOLDER TAIL, ALL OVER .000050 NICKEL

△6 .000015 GOLD IN THE CONTACT AREA, .000100-.000200 MATTE TIN ON THE SOLDER TAIL, ALL OVER .000050 NICKEL

△7 HIGH TEMPERATURE CONFIGURATION

△8 OBSOLETE PARTS: OBSOLETE CIS STREAMLINING PER D.RENAUD/D.SINISI

REMARKS	PLATING	C	B	A	NO OF POSN	ASSEMBLY PART NUMBER	PLATING	C	B	A	NO OF POSN	ASSEMBLY PART NUMBER
	7 6	3.984	3.900	39	80	9-103326-0	5	3.984	3.900	39	80	4-103326-0
	7 6	3.884	3.800	38	78	~~△8 8-103326-9~~	5	3.884	3.800	38	78	~~△8 3-103326-9~~
	7 6	3.784	3.700	37	76	~~△8 8-103326-8~~	5	3.784	3.700	37	76	~~△8 3-103326-8~~
	7 6	3.684	3.600	36	74	~~△8 8-103326-7~~	5	3.684	3.600	36	74	~~△8 3-103326-7~~
	7 6	3.584	3.500	35	72	~~△8 8-103326-6~~	5	3.584	3.500	35	72	~~△8 3-103326-6~~
	7 6	3.484	3.400	34	70	~~△8 8-103326-5~~	5	3.484	3.400	34	70	~~△8 3-103326-5~~
	7 6	3.384	3.300	33	68	~~△8 8-103326-4~~	5	3.384	3.300	33	68	~~△8 3-103326-4~~
	7 6	3.284	3.200	32	66	~~△8 8-103326-3~~	5	3.284	3.200	32	66	~~△8 3-103326-3~~
	7 6	3.184	3.100	31	64	~~△8 8-103326-2~~	5	3.184	3.100	31	64	~~△8 3-103326-2~~
	7 6	3.084	3.000	30	62	~~△8 8-103326-1~~	5	3.084	3.000	30	62	~~△8 3-103326-1~~
	7 6	2.984	2.900	29	60	~~△8 8-103326-0~~	5	2.984	2.900	29	60	~~△8 3-103326-0~~
	7 6	2.884	2.800	28	58	~~△8 7-103326-9~~	5	2.884	2.800	28	58	~~△8 2-103326-9~~
	7 6	2.784	2.700	27	56	~~△8 7-103326-8~~	5	2.784	2.700	27	56	~~△8 2-103326-8~~
	7 6	2.684	2.600	26	54	~~△8 7-103326-7~~	5	2.684	2.600	26	54	~~△8 2-103326-7~~
	7 6	2.584	2.500	25	52	~~△8 7-103326-6~~	5	2.584	2.500	25	52	~~△8 2-103326-6~~
	7 6	2.484	2.400	24	50	~~△8 7-103326-5~~	5	2.484	2.400	24	50	~~△8 2-103326-5~~
	7 6	2.384	2.300	23	48	~~△8 7-103326-4~~	5	2.384	2.300	23	48	~~△8 2-103326-4~~
	7 6	2.284	2.200	22	46	~~△8 7-103326-3~~	5	2.284	2.200	22	46	~~△8 2-103326-3~~
	7 6	2.184	2.100	21	44	~~△8 7-103326-2~~	5	2.184	2.100	21	44	~~△8 2-103326-2~~
	7 6	2.084	2.000	20	42	~~△8 7-103326-1~~	5	2.084	2.000	20	42	~~△8 2-103326-1~~
	7 6	1.984	1.900	19	40	~~△8 7-103326-0~~	5	1.984	1.900	19	40	2-103326-0
	7 6	1.884	1.800	18	38	~~△8 6-103326-9~~	5	1.884	1.800	18	38	~~△8 1-103326-9~~
	7 6	1.784	1.700	17	36	6-103326-8	5	1.784	1.700	17	36	~~△8 1-103326-8~~
	7 6	1.684	1.600	16	34	~~△8 6-103326-7~~	5	1.684	1.600	16	34	~~△8 1-103326-7~~
	7 6	1.584	1.500	15	32	~~△8 6-103326-6~~	5	1.584	1.500	15	32	~~△8 1-103326-6~~
	7 6	1.484	1.400	14	30	~~△8 6-103326-5~~	5	1.484	1.400	14	30	~~△8 1-103326-5~~
	7 6	1.384	1.300	13	28	6-103326-4	5	1.384	1.300	13	28	~~△8 1-103326-4~~
	7 6	1.284	1.200	12	26	6-103326-3	5	1.284	1.200	12	26	1-103326-3
	7 6	1.184	1.100	11	24	~~△8 6-103326-2~~	5	1.184	1.100	11	24	~~△8 1-103326-2~~
	7 6	1.084	1.000	10	22	~~△8 6-103326-1~~	5	1.084	1.000	10	22	~~△8 1-103326-1~~
	7 6	.984	.900	9	20	6-103326-0	5	.984	.900	9	20	~~△8 1-103326-0~~
	7 6	.884	.800	8	18	~~△8 5-103326-9~~	5	.884	.800	8	18	~~△8 103326-9~~
	7 6	.784	.700	7	16	~~△8 5-103326-8~~	5	.784	.700	7	16	103326-8
	7 6	.684	.600	6	14	5-103326-7	5	.684	.600	6	14	103326-7
	7 6	.584	.500	5	12	5-103326-6	5	.584	.500	5	12	103326-6
	7 6	.484	.400	4	10	5-103326-5	5	.484	.400	4	10	103326-5
	7 6	.384	.300	3	8	5-103326-4	5	.384	.300	3	8	~~△8 103326-4~~
	7 6	.284	.200	2	6	5-103326-3	5	.284	.200	2	6	~~△8 103326-3~~
	7 6	.184	.100	1	4	5-103326-2	5	.184	.100	1	4	~~△8 103326-2~~
	7 6	.084			2	~~△8 5-103326-1~~	5	.084			2	~~△8 103326-1~~

THIS DRAWING IS A CONTROLLED DOCUMENT.

DIMENSIONS: INCHES

TOLERANCES UNLESS OTHERWISE SPECIFIED:
0 PLC ± -
1 PLC ± -
2 PLC ± -
3 PLC ± -
4 PLC ± -
ANGLES ± -

MATERIAL

FINISH SEE TABLE

DWN H. MOLL 23-10-87
CHK T. CLARK 23-10-87
APVD T. CLARK 29-10-87
PRODUCT SPEC —
APPLICATION SPEC —
WEIGHT —

TE Connectivity

NAME HEADER ASSY, MOD II, BREAKAWAY, DOUBLE ROW, .100X.100 C/L, RIGHT ANGLE, WITH .025 SQ POSTS

SIZE	CAGE CODE	DRAWING NO	RESTRICTED TO
A2	00779	C-103326	—

CUSTOMER DRAWING | SCALE 1:1 | SHEET 2 OF 2 | REV G2

103326