
THIS DRAWING IS UNPUBLISHED. RELEASED FOR PUBLICATION -,- .
© COPYRIGHT - By - ALL RIGHTS RESERVED.

LOC	DIST
AF	50

REVISIONS

P	LTR	DESCRIPTION	DATE	DWN	APVD
	L2	REVISED PER ECO-11-004820	11MAR11	RK	HMR

△6 OBSOLETE PARTS: OBSOLETE CIS STREAMLINING PER D.RENAUD/D.SINISI

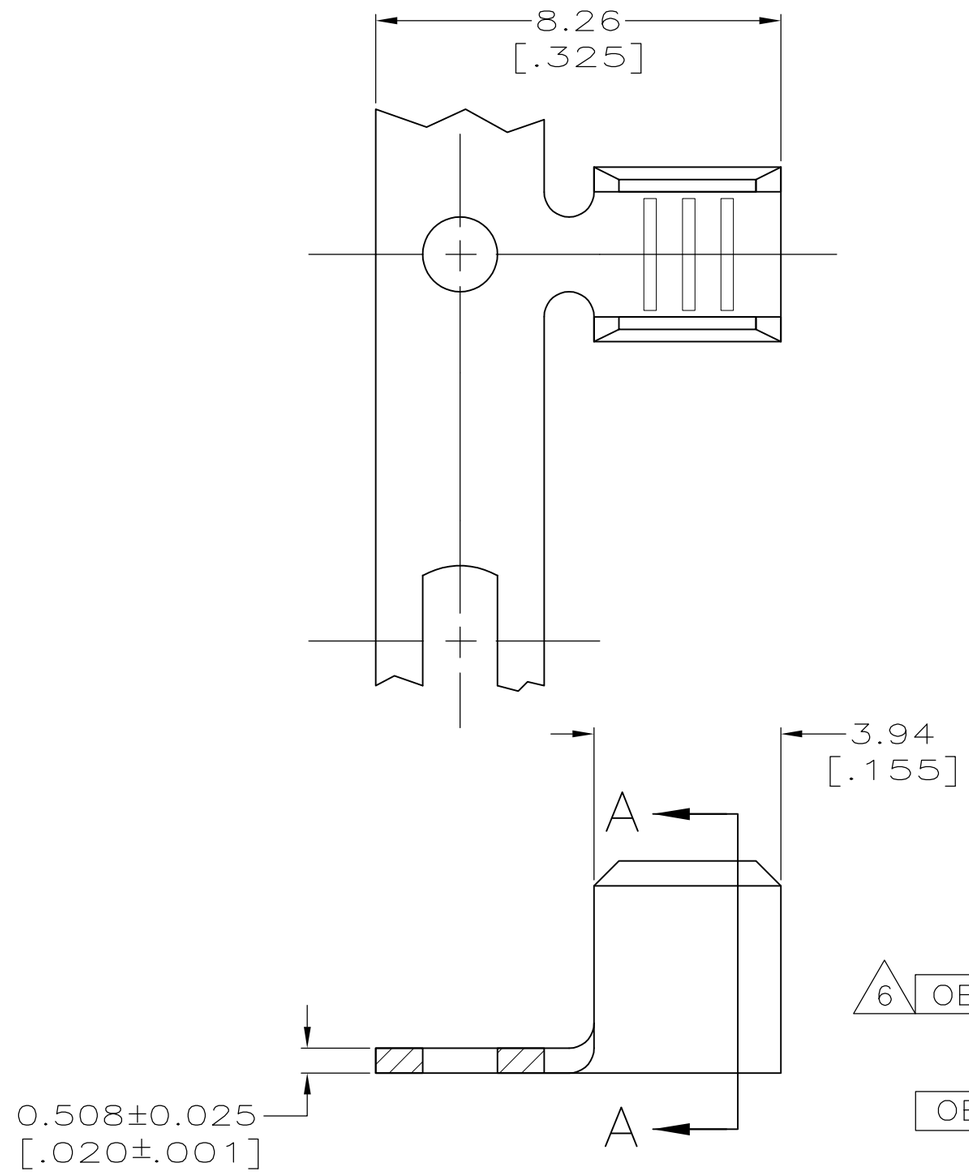


1 PRODUCT PROVIDED IN STRIP FORM ON REELS, BREAKS MAY BE PRESENT.

△3 CRIMP WIDTH, .110 F TYPE
CRIMP HEIGHT (±.002) = (TOTAL CMA + 11,300) / 176,700

△4 PRELIMINARY - NOT FOR PRODUCTION.

△5 WIRE RANGE FOR NEW APPLICATIONS: 1500-5000 CMA (WIRE RANGE APPROVED FOR APPLICATIONS IMPLEMENTED PRIOR TO 2005: 1970-4940 CMA).

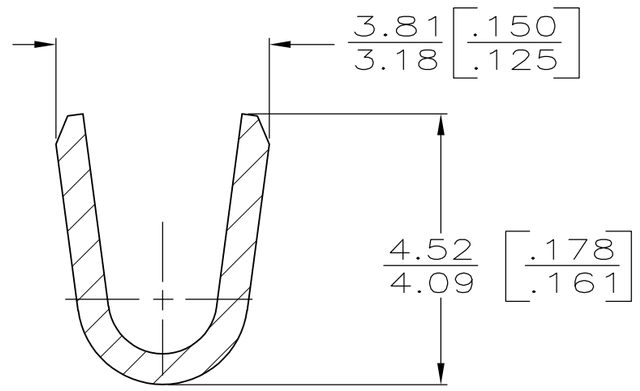

SECTION A-A
SCALE 10:1

	MATERIAL	FINISH	REELING	WIRE RANGE	PART NUMBER
	1010 STEEL	NICKEL	REVERSE	-	△4 63130-8
	H02 COPPER-NICKEL	NONE			△4 63130-7
△6 OBSOLETE	H02 PHOS BRONZE	TIN			△5 ~~63130-4~~
	082 BRASS			-	63130-3
		NONE			△3 63130-2
OBSOLETE			~~STANDARD~~		~~63130-1~~

THIS DRAWING IS A CONTROLLED DOCUMENT.

DIMENSIONS: INCHES

TOLERANCES UNLESS OTHERWISE SPECIFIED:
0 PLC ± -
1 PLC ± -
2 PLC ± 0.25 [.010]
3 PLC ± -
4 PLC ± -
ANGLES ± -

MATERIAL: SEE TABLE
FINISH: SEE TABLE

DWN PHILLIP M FORTNEY 17/JAN/96
CHK JEFF R RUTH 17/JAN/96
APVD DENNIS SCHWENK 17/JAN/96
PRODUCT SPEC —
APPLICATION SPEC 114-2088
WEIGHT —

TE Connectivity

NAME SPLICE

SIZE	CAGE CODE	DRAWING NO	RESTRICTED TO
A3	00779	C-63130	—

CUSTOMER DRAWING | SCALE 8:1 | SHEET 1 OF 1 | REV L2