

THIS DRAWING IS UNPUBLISHED. RELEASED FOR PUBLICATION －,－ .
© COPYRIGHT － By Tyco Electronics Japan G.K. ALL RIGHTS RESERVED.


| LOC | DIST |
|---|---|
| J | — |

REVISIONS

| P | LTR | DESCRIPTION | DATE | DWN | APVD |
|---|---|---|---|---|---|
| | C8 | REVISED | 27JUL2012 | H.M | N.Y |

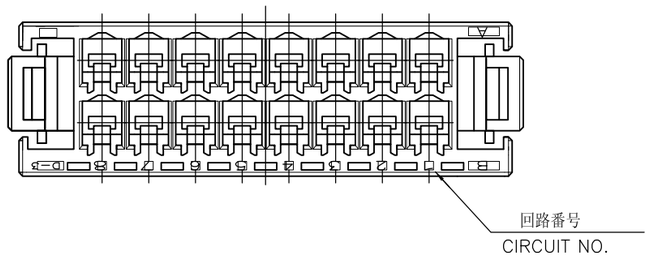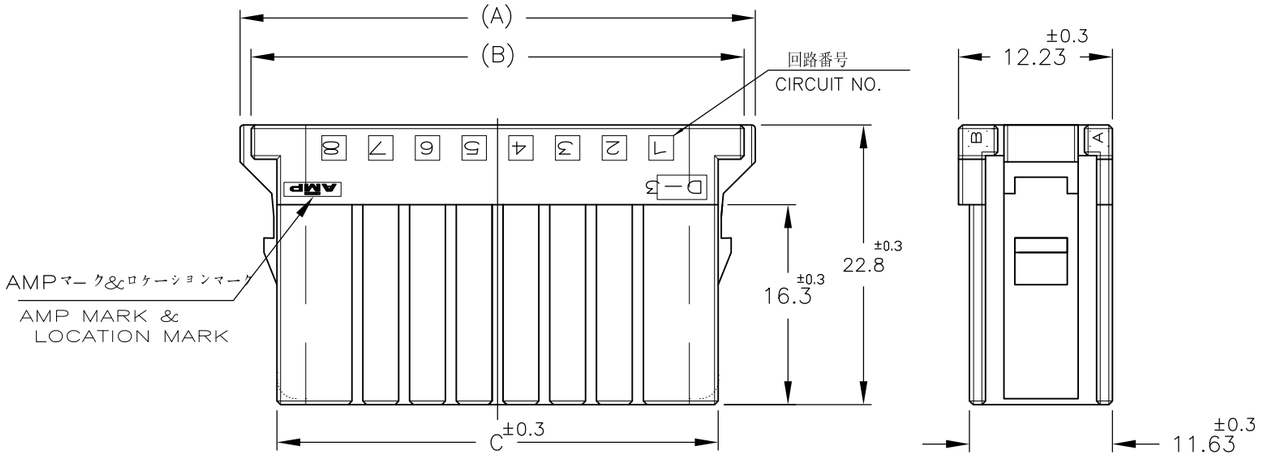


NOTE
1 MATERIAL:GLASS FIELD THERMO PLASTIC,POLYESTER
COLOR;BLACK
~~△2 TO COAT ALL SURFACE OF HOUSING WITH TEFLON~~
3 THE SHAPE,SIZE AND POSITION OFTHE CHARACTER
SHOW THE OUTLINE THEY DON'T SHOW DETAILS

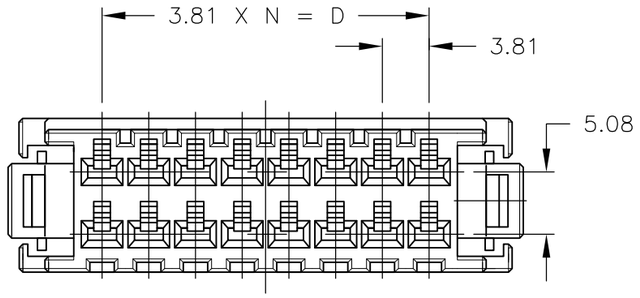注記
1 材料：ガラス入り熱可塑性ポリエステル樹脂
色：黒色
~~△2 ハウジング全面にテフロン塗装のこと~~
3 文字の形状、大きさ、および位置については、大略を示すものであり、
詳細を示すものではありません。

| | | POS. | A | B | C | D | N | PART NUMBER |
|---|---|---|---|---|---|---|---|---|
| | | 20 POS. | 51.03 | 47.83 | 43.37 | 34.29 | 9 | 178289-8 |
| OBSOLETE | △2 | ~~16 POS.~~ | | | | | | ~~5-178289-7~~ |
| | | 16 POS. | | SEE SHEET 2OF2 | | | | 178289-7 |
| | | 12 POS. | 35.79 | 32.59 | 28.13 | 19.05 | 5 | 178289-6 |
| OBSOLETE | △2 | ~~10 POS.~~ | ~~31.98~~ | ~~28.78~~ | ~~24.32~~ | ~~15.24~~ | ~~4~~ | ~~5-178289-5~~ |
| | | 10 POS. | 31.98 | 28.78 | 24.32 | 15.24 | 4 | 178289-5 |
| | | 8 POS. | 28.17 | 24.97 | 20.51 | 11.43 | 3 | 178289-4 |
| OBSOLETE | △2 | ~~6 POS.~~ | ~~24.36~~ | ~~21.16~~ | ~~16.70~~ | ~~7.62~~ | ~~2~~ | ~~5-178289-3~~ |
| | | 6 POS. | 24.36 | 21.16 | 16.70 | 7.62 | 2 | 178289-3 |

THIS DRAWING IS A CONTROLLED DOCUMENT.

DIMENSIONS: mm

TOLERANCES UNLESS OTHERWISE SPECIFIED:
0 PLC ±
1 PLC ± 10 > : ±0.2
2 PLC ± < 30 : ±0.25
3 PLC ± 30 < 100 : ±0.3
4 PLC ±
ANGLES ±3°

MATERIAL: SEE NOTE
FINISH: －

| | |
|---|---|
| DWN | N.MATSUBARA 09JUL1991 |
| CHK | H.OBATA 24FEB1992 |
| APVD | S.MANABE 04MAR1992 |
| PRODUCT SPEC | — |
| APPLICATION SPEC | — |
| WEIGHT | — |

TE Connectivity

NAME
REC HSG FOR DYNAMIC DPUBLE ROW
DYNAMIC D-3100 REC HSG
—

| SIZE | CAGE CODE | DRAWING NO | RESTRICTED TO |
|---|---|---|---|
| A3 | 00779 | C-178289 | — |


CUSTOMER DRAWING | SCALE 2:1 | SHEET 1 OF 2 | REV C8


THIS DRAWING IS UNPUBLISHED. RELEASED FOR PUBLICATION –,– .
© COPYRIGHT – By Tyco Electronics Japan G.K. ALL RIGHTS RESERVED.

| LOC | DIST |
|---|---|
| J | — |


REVISIONS

| P | LTR | DESCRIPTION | DATE | DWN | APVD |
|---|---|---|---|---|---|
| | – | SEE SHEET 1 | – | — | — |

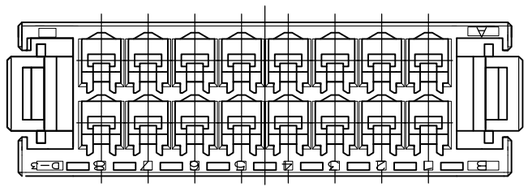

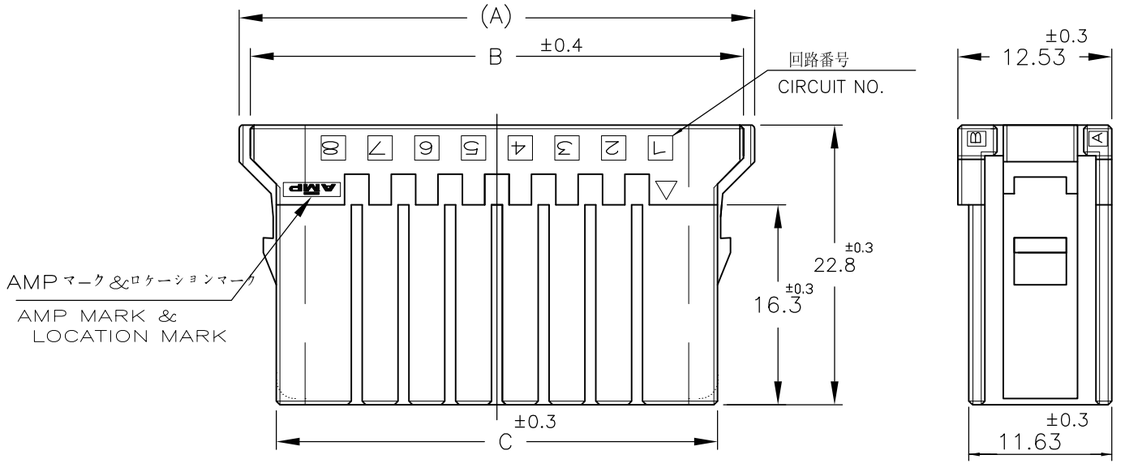


NOTE:SEE SHEET 1 OF 2

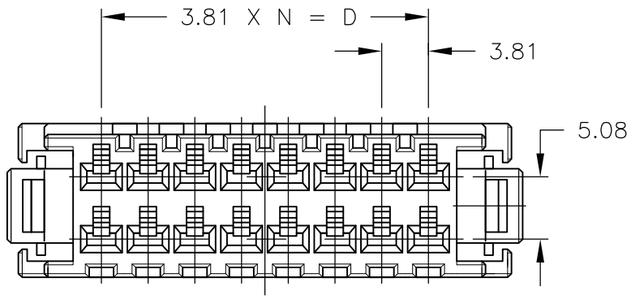


| | | | | | | | |
|---|---|---|---|---|---|---|---|
| OBSOLETE | △2 | | | | | | 5-178289-7 |
| | 16POS | 42.71 | 40.21 | 35.97 | 26.67 | 7 | 178289-7 |
| FINISH | POS. / DIMENSION | A | B | C | D | N | PART NUMBER |

THIS DRAWING IS A CONTROLLED DOCUMENT.

DIMENSIONS: mm

TOLERANCES UNLESS OTHERWISE SPECIFIED:
0 PLC ±
1 PLC ± 10 > : ±0.2
2 PLC ± < □30 : ±0.25
3 PLC ± 30 < □100 : ±0.3
4 PLC ±
ANGLES ±3°

MATERIAL: SEE NOTE

FINISH: –

DWN N.MATSUBARA 09JUL1991
CHK H.OBATA 24FEB1992
APVD S.MANABE 04MAR1992
PRODUCT SPEC —
APPLICATION SPEC —
WEIGHT —

TE Connectivity

NAME
REC HSG FOR DYNAMIC DPUBLE ROW
DYNAMIC D-3100 REC HSG
—

| SIZE | CAGE CODE | DRAWING NO | RESTRICTED TO |
|---|---|---|---|
| A3 | 00779 | C-178289 | — |

CUSTOMER DRAWING | SCALE 2:1 | SHEET 2 OF 2 | REV C8